091-019-000

Existing Conditions
Kozlowski Residence
Tax Map 91 Lot 19 New London, NH.
Landforms Ltd.
Bow, NH.
Scale 1" = 20'-0"

RECEIVED
JUL - 1 2015

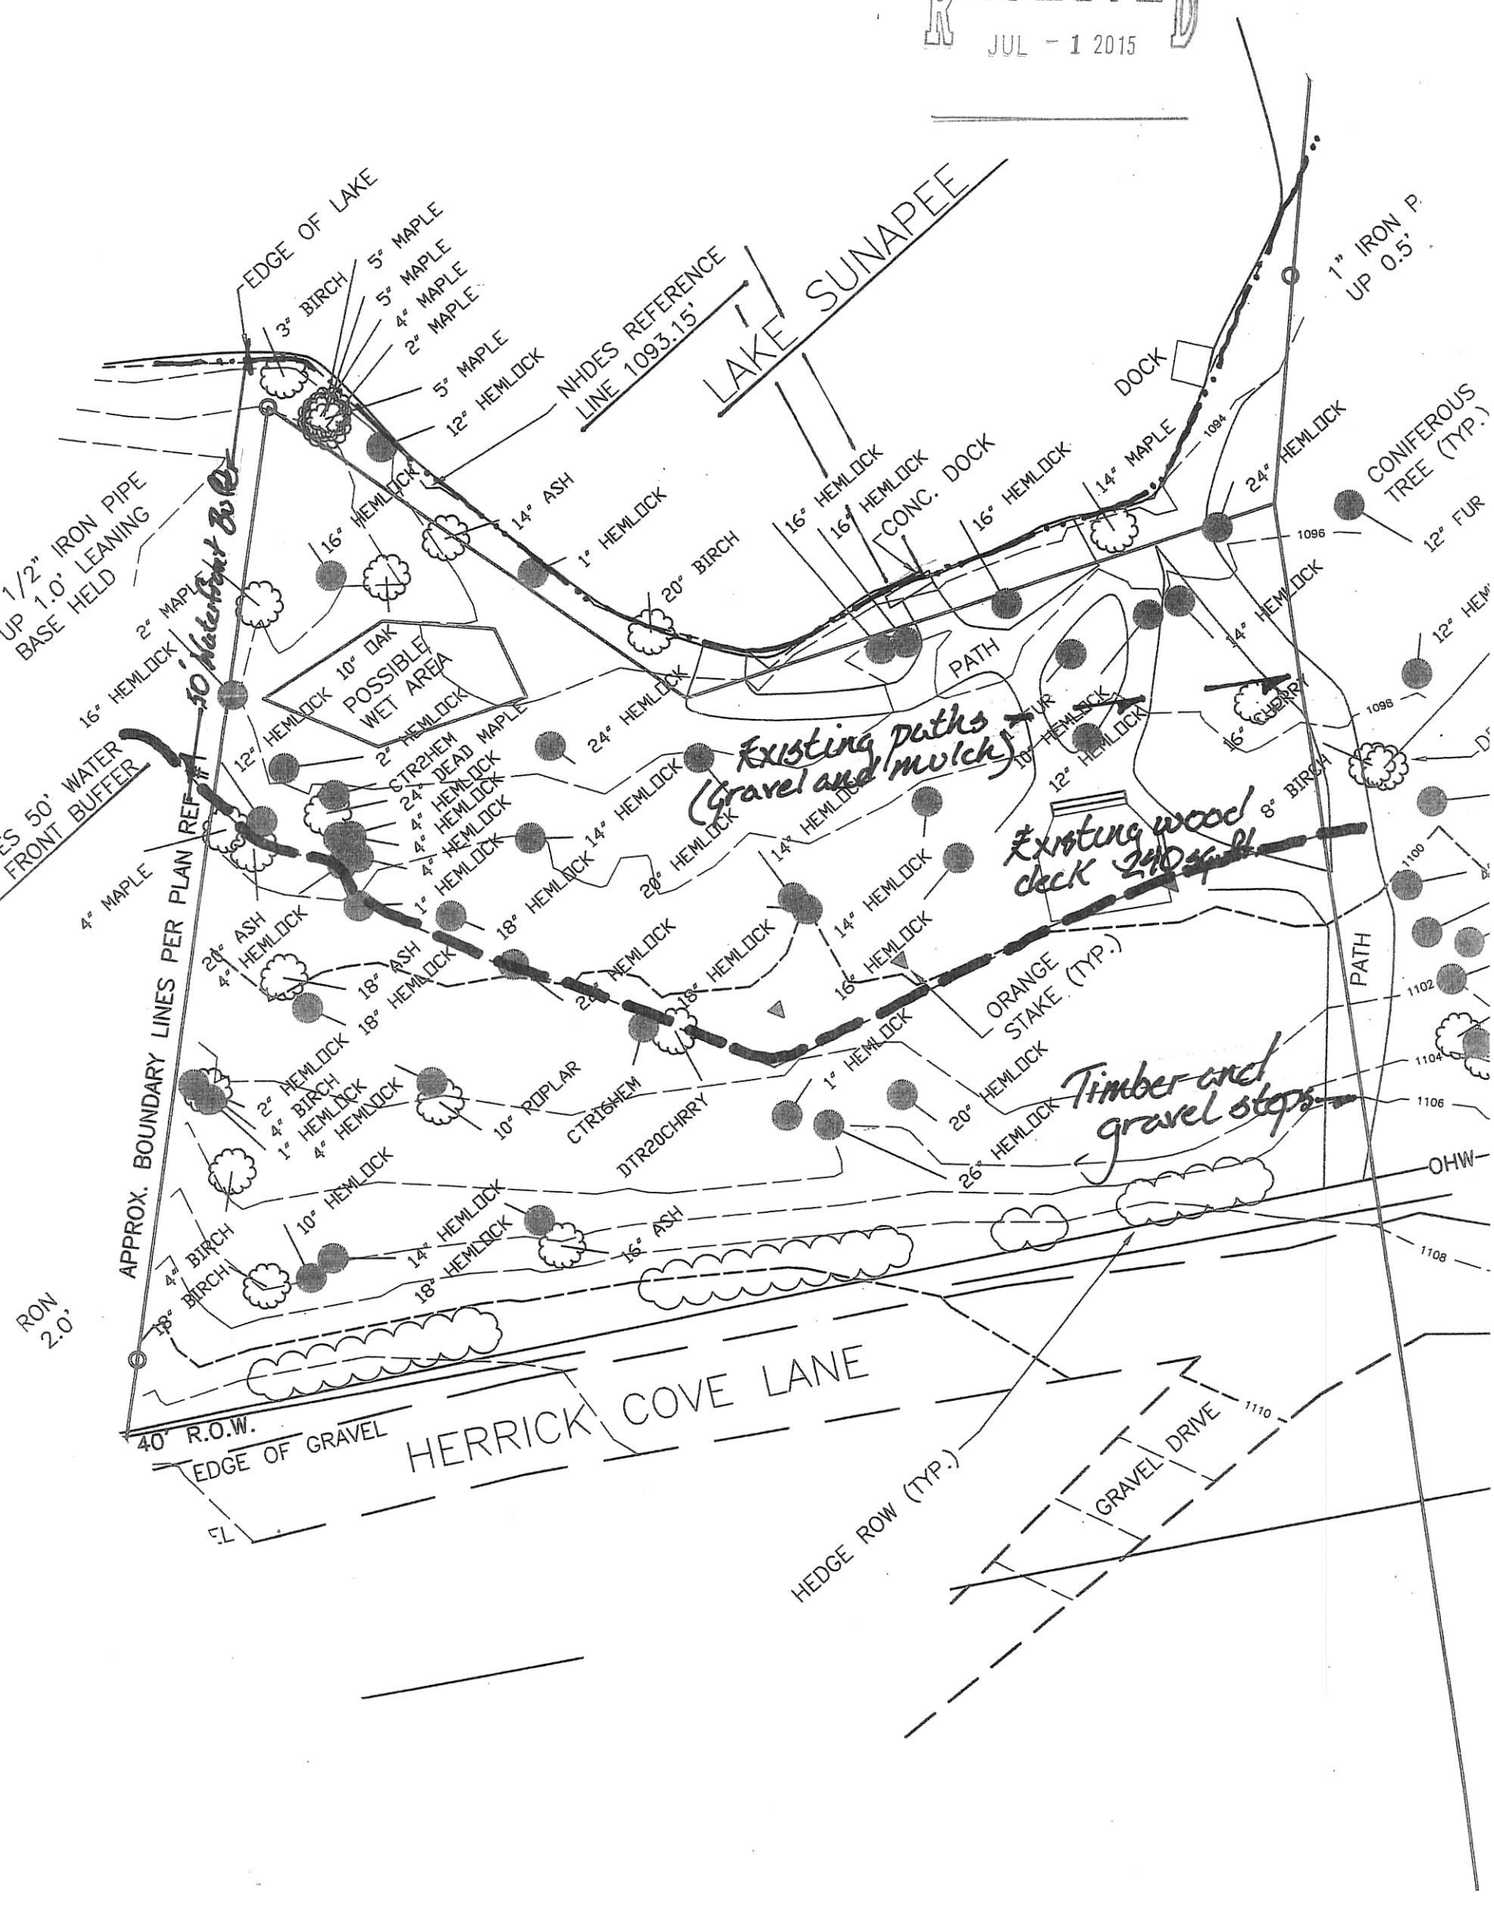

091-019-000

Conceptual Lakefront Plan
Kozlowski Residence

New London, NH.
Landforms Ltd.
Bow, NH.
Scale 1":20'-0"

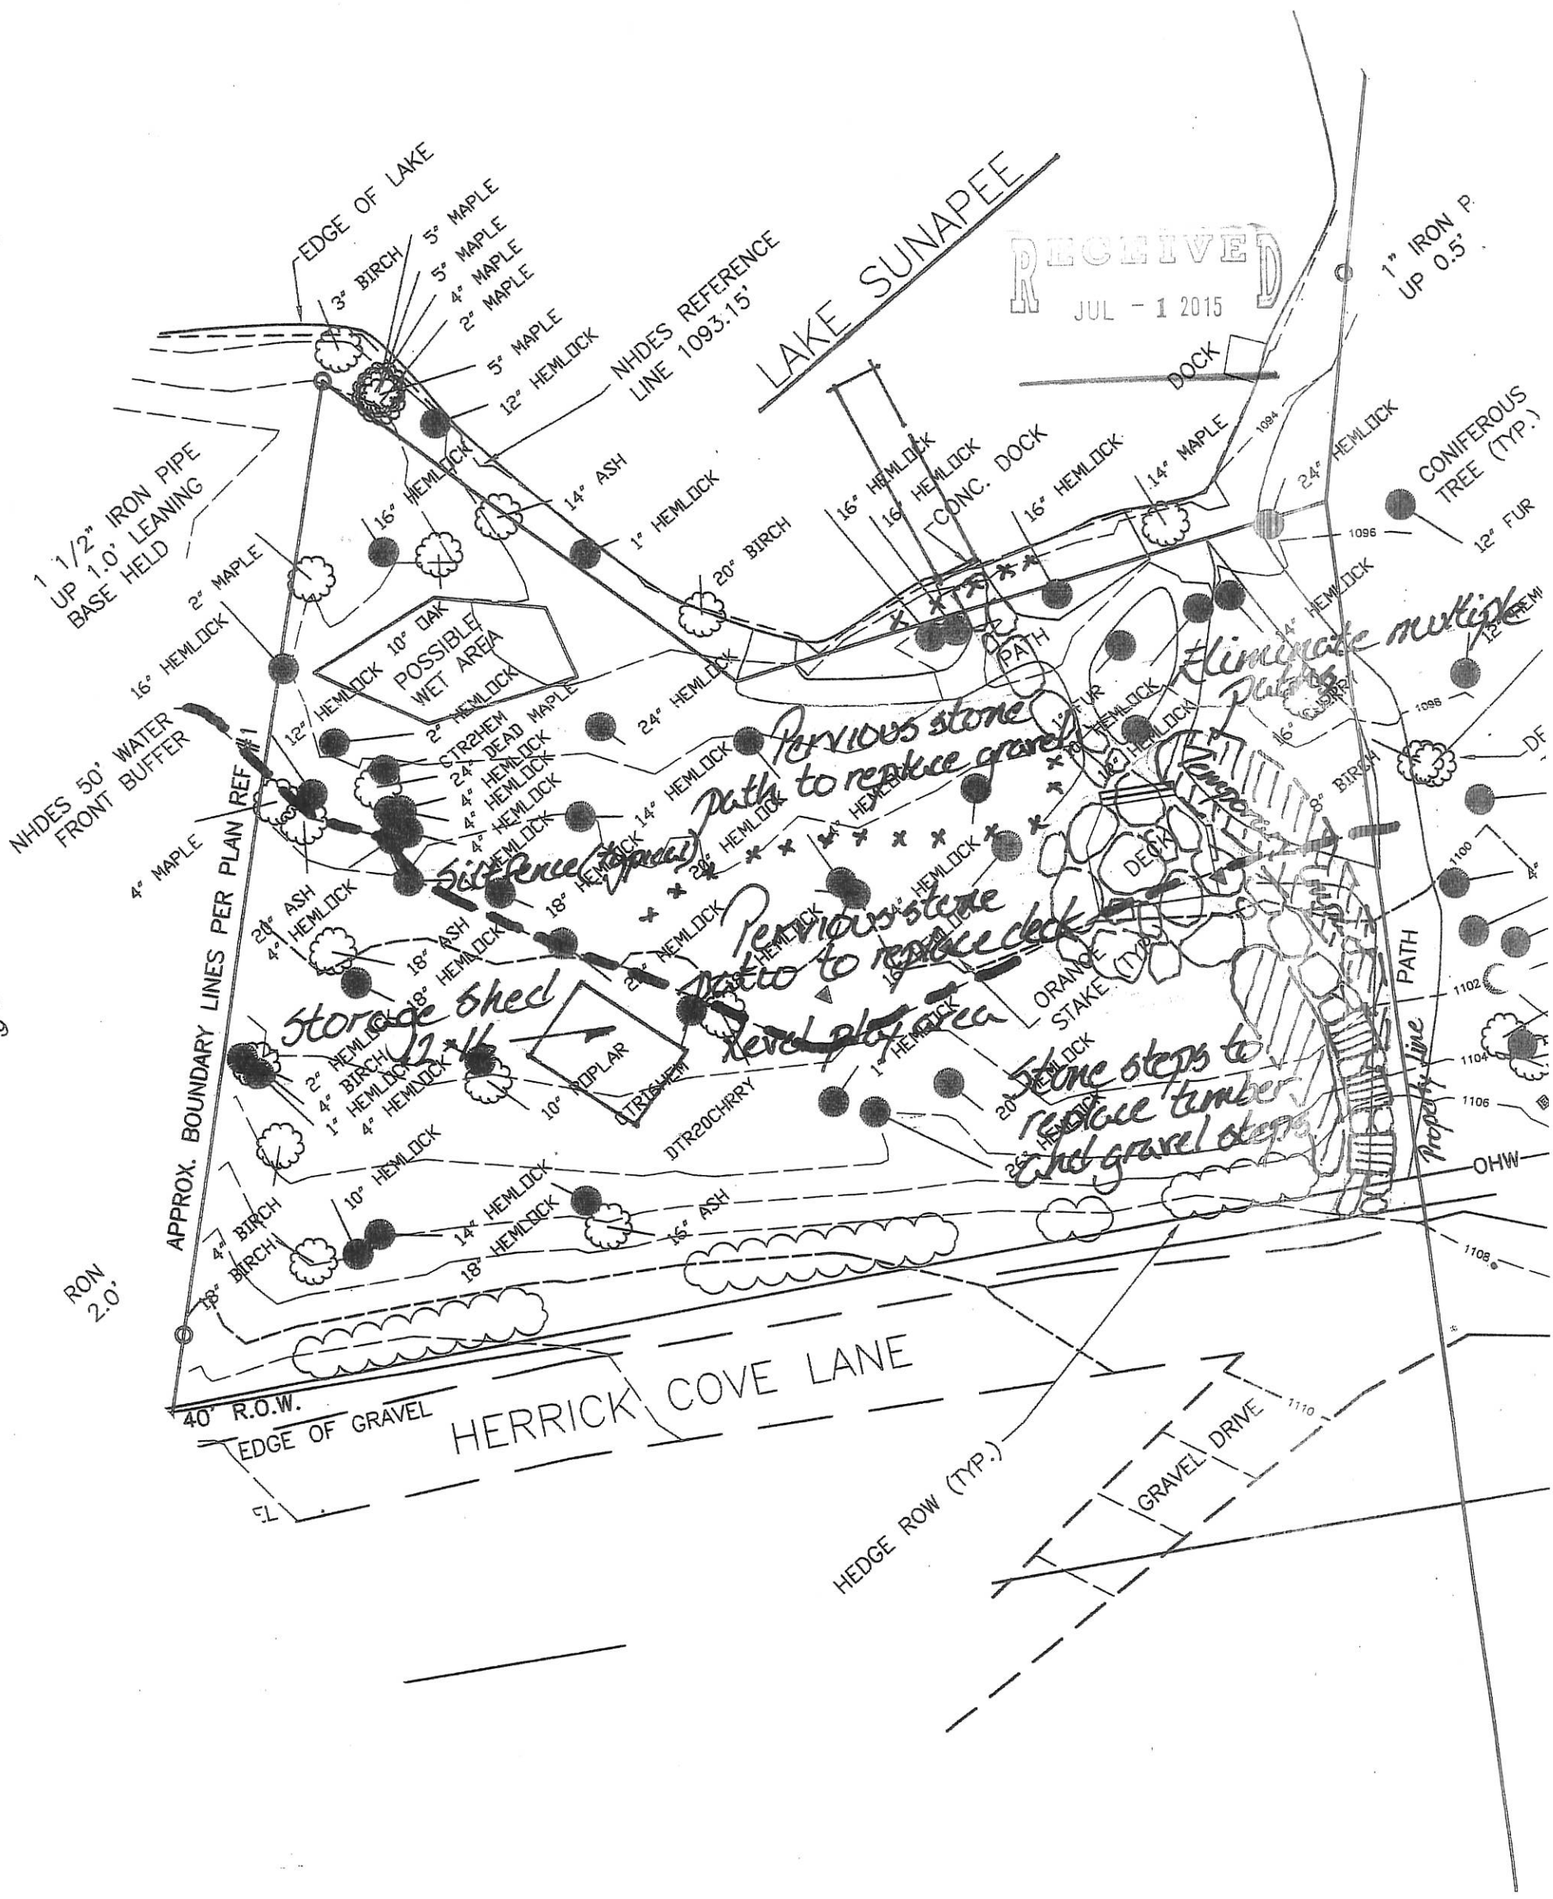

091-019-000

Revegetation Plan

Conceptual Lakefront Plan
Kozlowski Residence

New London, NH.

Landforms Ltd.

Bow, NH.

Scale 1":20'-0"

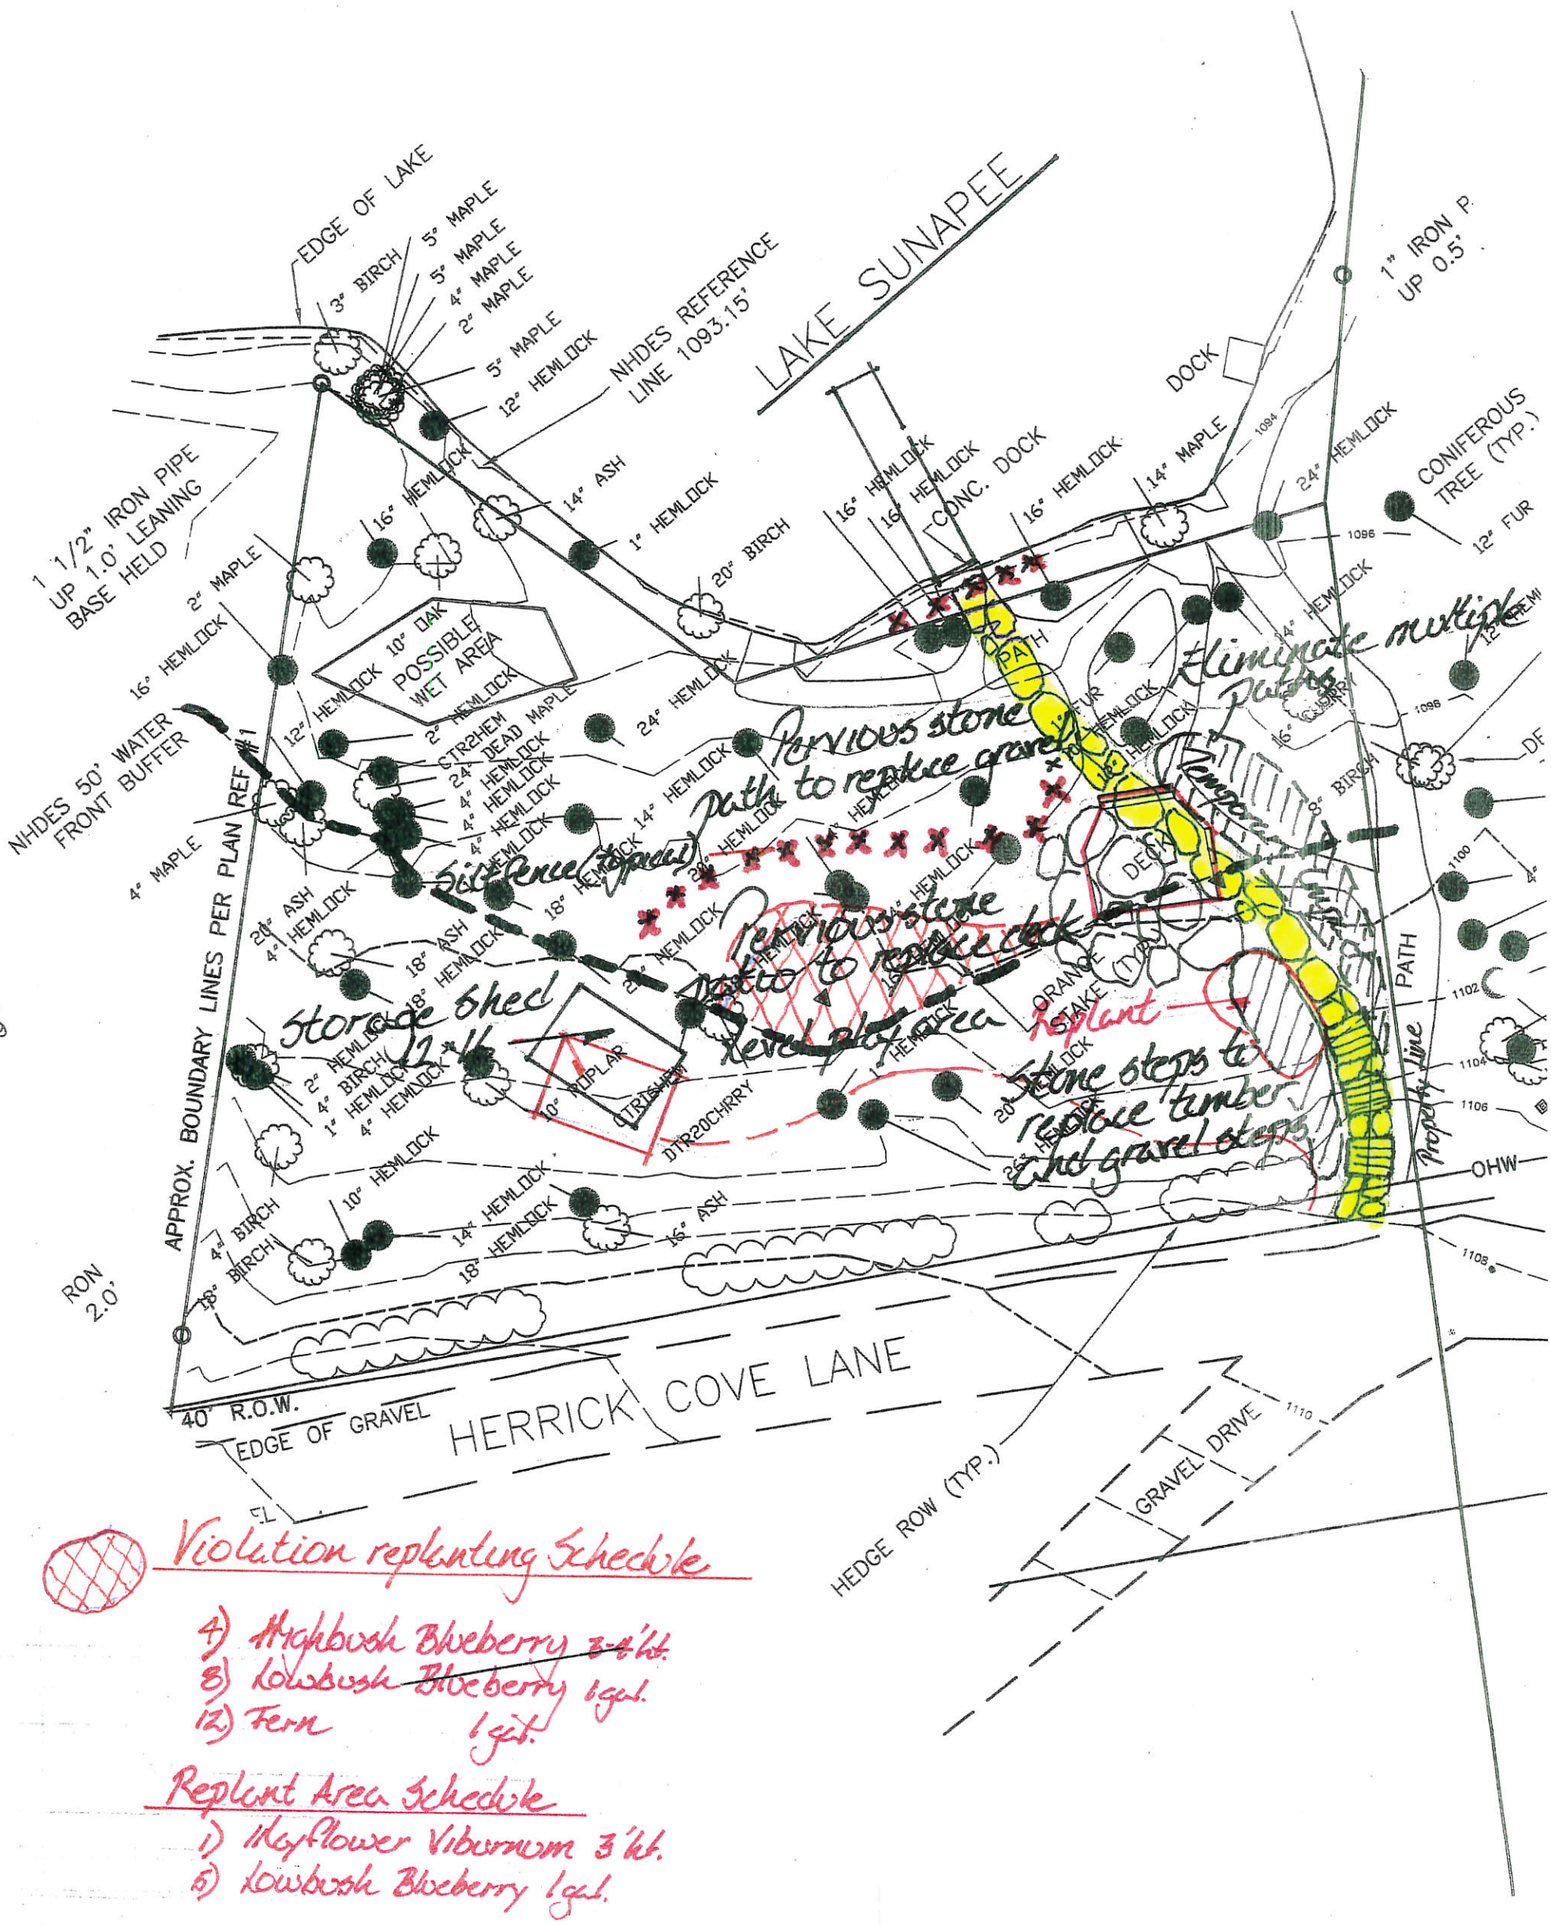

Violation replanting Schedule

4) Highbush Blueberry ~~3'-4' ht.~~
8) Lowbush ~~Blueberry~~ 1 gal.
12) Fern 1 gal.

Replant Area Schedule

1) Mayflower Viburnum 3' ht.
5) Lowbush Blueberry 1 gal.

091-019-000

Timber and gravel steps leading down from road

Typical existing paths; Mix of gravel and mulch covering

RECEIVED
JUL - 1 2015

Path from existing deck to dock location

Existing deck 240 sq. ft.

Kozlowski Residence

Tax map 91 Lot 19

All pictures taken 4-30-15

091-019-000

LANDFORMS

a Landscape Architects Collaborative.

RECEIVED
JUL - 1 2015

Silt Fence Detail
(Not to Scale)

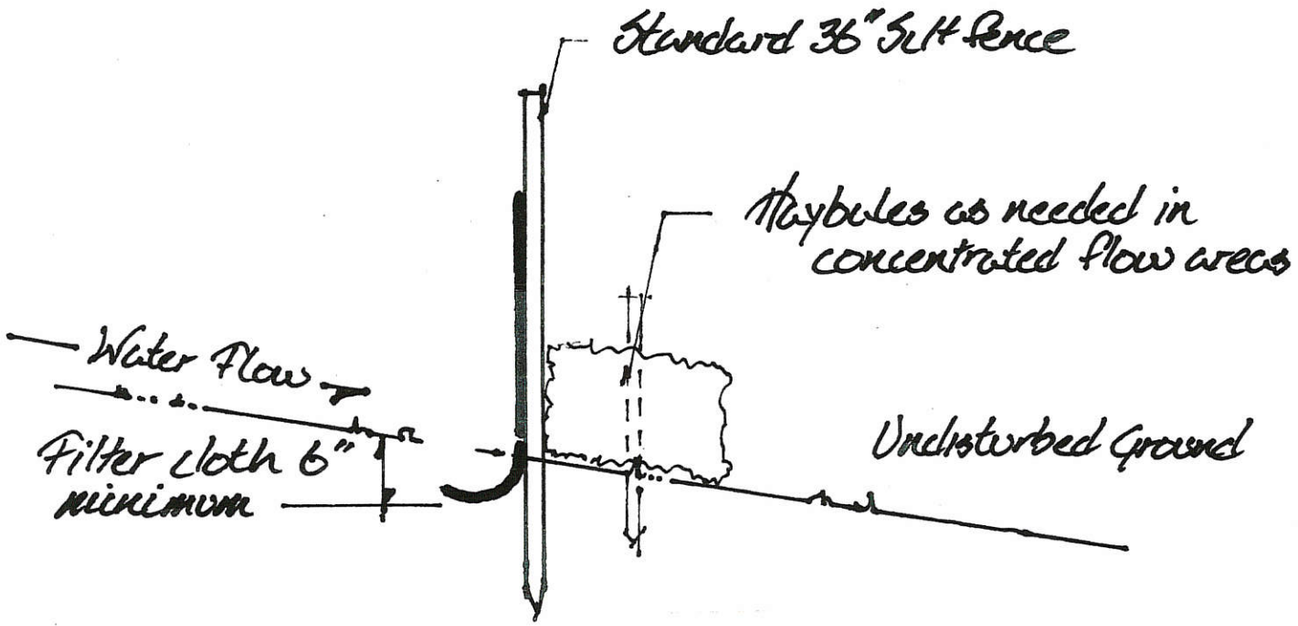

CONSTRUCTION NOTES FOR FABRICATED SILT FENCE

1. FILTER CLOTH TO BE FASTENED SECURELY TO FENCE POST WITH TIES AT TOP, MID SECTION AND BOTTOM.
2. WHEN TWO SECTIONS OF FILTER CLOTH ADJOIN EACH OTHER, THEY SHALL BE OVERLAPPED BY 6 INCHES, FOLDED STAPLED.
3. MAINTENANCE SHALL BE PERFORMED AS NEEDED TO PREVENT "BULGES" IN THE SILT FENCE DUE TO DEPOSITION OF SEDIMENT.

MAINTENANCE REQUIREMENTS

1. INSPECT SILT FENCES IMMEDIATELY AFTER EACH RAINFALL AND DAILY DURING PROLONGED RAINFALL. ANY NECESSARY REPAIRS SHALL BE MADE IMMEDIATELY.
2. IF THE FABRIC ON A SILT FENCE SHOULD DECOMPOSE OR BECOME INEFECTIVE DURING THE EXPECTED LIFE OF THE FENCE, THE FABRIC SHALL BE REPLACED PROMPTLY.
3. SEDIMENT DEPOSITS SHOULD BE REMOVED WHEN THEY REACH APPROXIMATELY ONE-HALF THE HEIGHT OF THE BARRIER.
4. SEDIMENT DEPOSITS THAT ARE REMOVED OR LEFT IN PLACE AFTER THE FABRIC HAS BEEN REMOVED SHALL BE GRADED TO CONFORM WITH THE EXISTING TOPOGRAPHY AND VEGETATED.

17 Dow Road • Bow, NH 03304 • (603) 228-2858 / (FAX) 228-2859
Land Planning • Landscape Architecture • Landscape Construction